


F H W A REGION NO.	STATE	FED. AID PROJ. NO.	SHEET NO.	TOTAL SHEETS
3	MD			

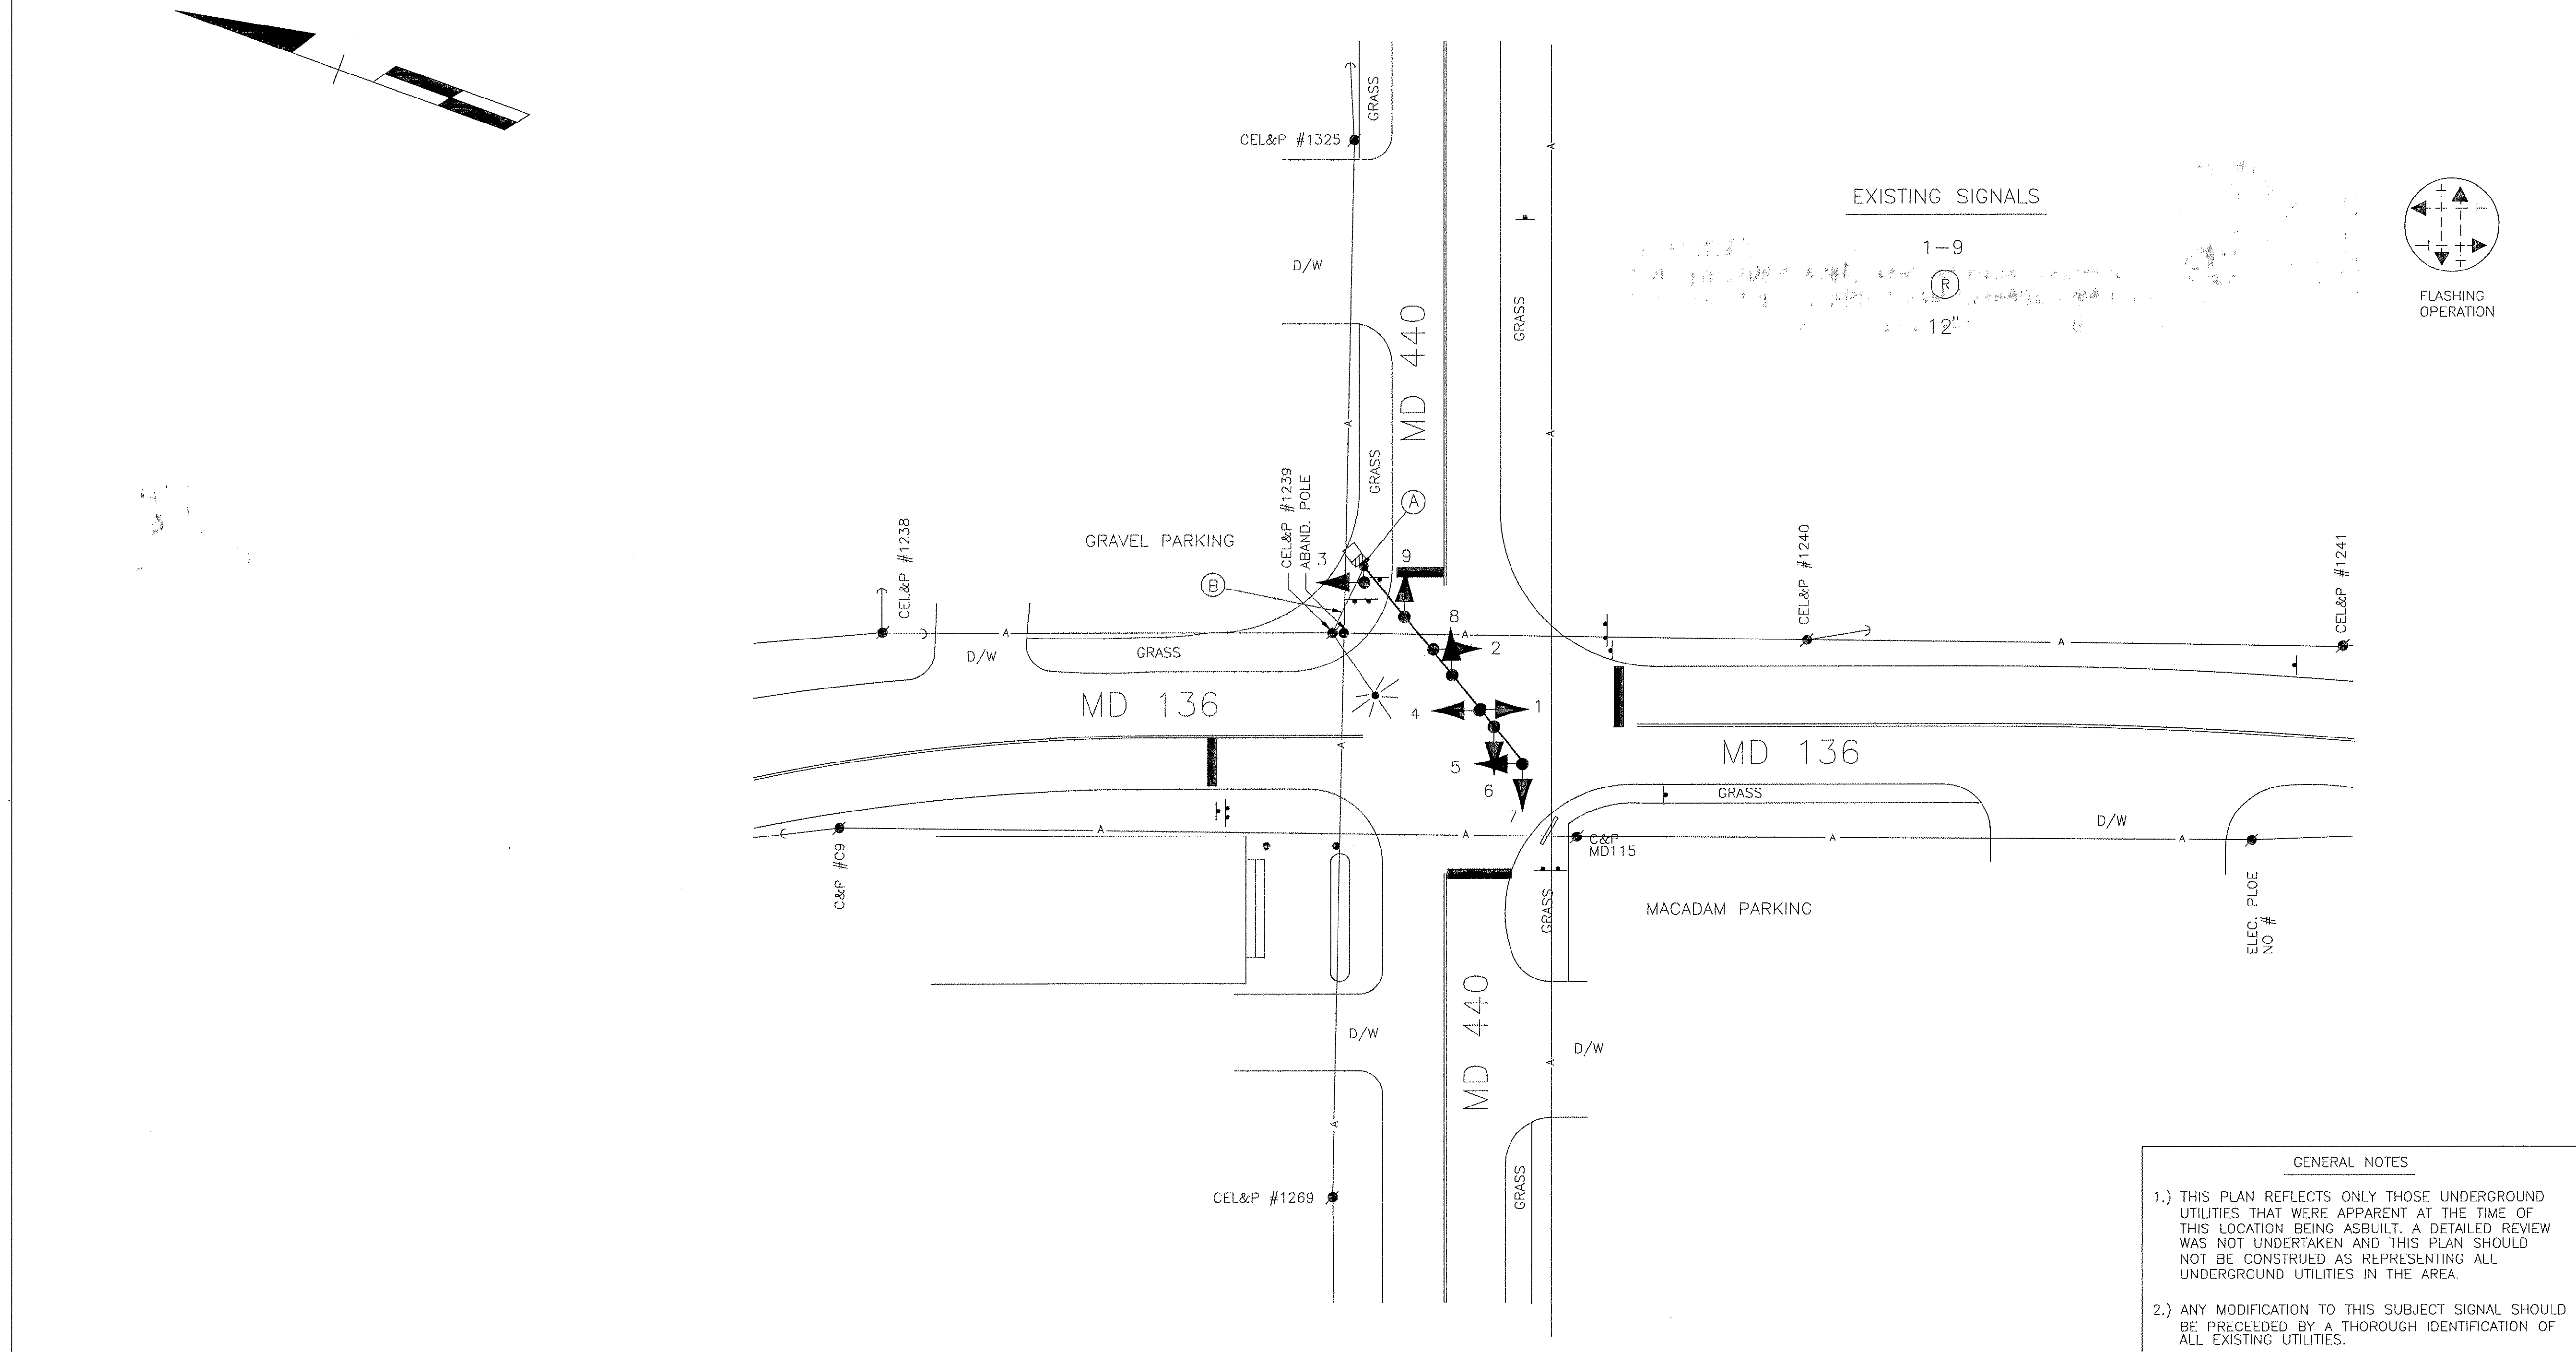

GENERAL NOTES

1.) THIS PLAN REFLECTS ONLY THOSE UNDERGROUND UTILITIES THAT WERE APPARENT AT THE TIME OF THIS LOCATION BEING ASBUILT. A DETAILED REVIEW WAS NOT UNDERTAKEN AND THIS PLAN SHOULD NOT BE CONSTRUED AS REPRESENTING ALL UNDERGROUND UTILITIES IN THE AREA.

2.) ANY MODIFICATION TO THIS SUBJECT SIGNAL SHOULD BE PRECEDED BY A THOROUGH IDENTIFICATION OF ALL EXISTING UTILITIES.

LEGEND OF UNDERGROUND AND OVERHEAD UTILITIES

AERIAL CABLE	— A — A —
ELECTRIC	— E — E —
TELEPHONE	— T — T —
GAS	— G — G —
SEWER	— S — S —
WATER	— W — W —
CABLE TV	— TV — TV —

STREET TRAFFIC STUDIES, LTD.  
Gateway International  
1302 Concourse Drive, Suite 104  
Linthicum, Maryland 21090  
(410) 859-3553

REVISIONS	APPROVALS
	CHIEF, SIGNAL DESIGN SECTION
	ASST. DISTRICT ENGINEER, TRAFFIC
	CHIEF, TRAFFIC ENGINEERING DESIGN DIVISION
	DIRECTOR, OFFICE OF TRAFFIC AND SAFETY

MDOT — STATE HIGHWAY ADMINISTRATION  
Office of Traffic and Safety  
TRAFFIC ENGINEERING DESIGN DIVISION

SIGNAL NUMBER :  
DRAWN BY: DY (FOR PEC)  
DES. BY: S. RENZI  
CHK. BY:

LOG MILE :12013612.81  
MD 136 @ MD 440  
COUNTY HARFORD

DATE: _____	F.A.P. NO. _____	TS/STD. NO. 3315	SHEET NO. _____
SCALE: 1"=20'	S.H.A. NO. _____		OF _____